
NOTES CONT'D: REFERENCES: BULK REQUIREMENTS ZONE: R-22 LEGEND FOR EROSION CONTROL DURING CONSTRUCTION 13. AREA OF DISTURBANCE-2,000 SF. -ALL BOUNDARY & TOPOGRAPHY INFORMATION IS REFERENCED 14. NO WATER SUPPLY IMPROVEMENTS ARE NECESSARY. MINIMUM LOT FRONT YARD LOT AREA (FLET) TOTAL SIDE REAR STREET FLOOR AREA SIDE YARD (FEET) MAXIMUM FROM A TOPOGRAPHIC SURVEY PREPARED BY ANTHONY R. 16. LOT DRAINAGE SHOWN SHALL CONSTITUTE EASEMENTS RUNNING WITH THE LAND & SHALL NOT BE DISTURBED. STAB. CONSTRUCTION ENTRANCE SETBACK FRONTAGE HEIGHT YARD (FEET) 17. THIS PLAN DOES NOT CONFLICT WITH THE COUNTY OFFICIAL MAP & HAS BEEN APPROVED IN THE MANNER SPECIFIED BY SECTION 239 L & M OF THE GENERAL CELENTANO, PLS DATED MARCH 28, 2023, PROVIDED BY OWNER. (FAR) (FEET) (FEET) MUNICIPAL LAW OF THE STATE OF NEW YORK. 19. FLEVATION DATUM IS USGS. 22,500 50. FT. 20' REO'D 75 0.20 20. THERE IS A 396 SF OF INCREASE IN IMPERVIOUS AREA FOR THE DECK. 40 125 45 EXIST 20.855.5 INLET PROTECTION NA 120.3 NA 50. FT.\* 121\* 19.4\* 77.1 226.2 28.1\* 20,855.5 50. fT.\* 121\* 120.3 NA PRO'D 77.1 214.2 NA 28.1\* 19.4\* 31 \* PRE-EXISTING CONDITION LOT AREA CALC: AREA = 38,166 SF -34,621\*.5(5LOPE >257 AREA = 20,855.5 SF I. AT LEAST ONE WEEK PRIOR TO COMMENCEMENT OF ANY WORK INCLUDING THE INSTALLATION OF EROSION CONTROL DEVICES OR THE REMOVAL OF TREES AND VEGETATION, A PRE-CONSTRUCTION MEETING MUST -6' THICKNESS OF 2' CRUSHED STONE BE HELD WITH THE TOWN OF ORANGETOWN NOTE CHAPTER 43, SECTION 5.21(B)(E) UNDERSIZED LOT APPLIES DEPARTMENT OF ENVIRONMENTAL MANAGEMENT WITH REGARD TO SIDE YARD & HEIGHT. ENGINEERING, SUPERINTENDENT OF HIGHWAYS AND THE OFFICE OF BUILDING ZONING AND PLANNING C MLTER FABRIC- TREVIRA NO. 1127 OR APPROVED EQUAL ADMINISTRATION AND ENFORCEMENT. IT IS THE \_\_EXISTING DRIVEWAY RESPONSIBILITY AND OBLIGATION OF THE PROPERTY OWNER TO ARRANGE SUCH A MEETING. 2. STORMWATER MANAGEMENT PLIASE II REGULATIONS: ADDITIONAL CERTIFICATION, BY AN APPROPRIATE STABILIZED CONSTRUCTION ENTRANCE LICENSED OR CERTIFIED DESIGN PROFESSIONAL SHALL BE REQUIRED FOR ALL MATTERS BEFORE THE N.T.S. PLANNING BOARD INDICATING THAT THE DRAWINGS AND PROJECT ARE IN COMPLIANCE WITH THE STORMWATER MANAGEMENT PHASE II REGULATIONS. 5. THE TREE PROTECTION AND PRESERVATING GUIDELINES ADOPTED PURSUANT TO SECTION 21-24 OF THE LAND DEVELOPMENT REGULATIONS OF THE THE TOWN OF ORANGETOWN WILL BE IMPLEMENTED IN ORDER TO PROTECT AND PRESERVE BOTH INDIVIDUAL SPECIMEN TREES AND BUFFER AREA WITH MANY TREES, STEPS THAT WILL BE TAKEN TO RESERVE AND PROTECT EXISTING TREES TO REMAIN ARE AS VICINITY MAP A. NO CONSTRUCTION EQUIPMENT SHALL BE PARKED UNDER TREE CANOPY. 3. THERE WILL BE NO EXCAVATION OR STOCKPILING 1' = 200'OF EARTH UNDERNEATH THE TREES.
C. TREES DESIGNATED TO BE PRESERVED SHALL BE EXTRA STRENGTH HILTER FABRIC MARKED CONSPICUOUSLY ON ALL SIDES AT A 5 TO 10 NEEDED WITHOUT WIRE MESH SUPPORT D. THE TREE PROTECTION ZONE FOR TREES DESIGNATED TO BE PRESERVED WILL BE ESTABLISHED BY ONE OF THE FOLLOWING METHODS: -ONE (I) FOOT RADIUS FROM TRUNK PER INCHI DBH -DRIP LINE OF THE TREE CANOPY THE METHOD CHOSEN SHOULD BE BASED ON PROVIDING THE MAXIMUM PROTECTION ZONE POSSIBLE A BARRIER OF SNOW FENCE OR QUAL IS TO BE PLACED AND MAINTAINED ONE YARD BEYOND THE ESTABLISHED TREE PROTECTION ZONE. IF IT IS AGREED THAT THE TREE PROTECTION ZONE OF A V8334WE SELECTED TREE MUST BE VIOLATED, ONE OF THE FOLLOWING METHODS MUST BE EMPLOYED TO MITIGATE THE IMPACT: -LIGHT TO LICAVY IMPACTS - MINIMUM OF EIGHT INCHES OF WOOD CHIPS INSTALLED IN THE AREA TO BE PROTECTED. CHIPS SHALL BE REMOVED UPON COMPLETION OF WORK. PONDING HT. -LIGHT IMPACTS ONLY - INSTALLATION OF 3/4" OF PLYWOOD OR BOARDS, OR EQUAL OVER THE AREA TO BE PROTECTED. THE BUILDER OR ITS AGENT MAY NOT CHANGE GRADE WITH THE TREE PROTECTION ZONE OF A PRESERVED TREE UNLESS SUCH GRADE CHANGE HAS RECEIVED FINAL APPROVAL FOR THE PLANNING BOARD. IF THE GRADE LEVEL IS TO BE CHANGED MORE THAN 6(5)XI INCHES, TREES DESIGNATED TO BE PRESERVED SHALL BE WELLED AND/OR PRESERVED IN A RAISED BED, WITH THE TREE WELL A RADIUS OF THREE (3) FEET LARGER THAT THE TREE CANOPY. 4. ALL LANDSCAPING SHOWN ON THE SITE PLANS SHALL BE MAINTAINED IN A VIGOROUS GROWING CONDITION THROUGHOUT THE DURATION OF THE USE OF THE SITE, ANY PLANTS NOT SO MAINTAINED STANDARD DETAIL ALTERNATE DETAI SHALL BE REPLACED WITH NEW PLANTS AT THE BEGINNING OF THE NEXT IMMEDIATELY FOLLOWING TRENCH WITH NATIVE BACKROTIC TRENCH WITH GRAVEL GROWING SEASON. 5. PRIOR TO THE COMMENCEMENT OF ANY SITE WORK I. INSPECT AND REPAIR FENCE AFTER EACH STORM EVENT AND REMOVE SEDIMENT WHEN INCLUDING THE REMOVAL OF TREES, THE APPLICANT Same and the same SHALL INSTALL SOIL EROSINO AND SEDIMENTATION TO AN AREA THAT WILL NOT CONTRIBUTE CONTROL AS REQUIRED BY THE PLANNING BOARD. STRAW PRIOR TO THE AUTHORIZATION TO PROCEED WITH ANY SEDIMENT OFF-SITE AND CAN BE PERMANENTLY 31.9 C DIKE (TYP.) PHASE OF THE SITE WORK, THE TOWN OF STABILIZED.

5. SILT FENCE SHALL BE PLACED ON SLOPE CONTOURS TO MAXIMIZE PONDING EFFICIENCY. ORANGETOWN DEPARTMENT OF ENVIRONMENTAL MANAGEMENT AND ENGINEERINGIDEME! SHALL INSPECT THE INSTALLATION OF ALL REQUIRED SOIL FROSION AND SEDIMENTATION CONTROL MEASURES. THE APPLICANT SHALL CONTACT DEME AT LEAST 48 HOURS IN ADVANCE OF AN INSPECTION. 6. THE CONTRACTOR'S TRAILER, IT ANY IS PROPOSED, SHALL BE LOCATED AS APPROVED BY THE PLANNING 7. IF THE APPLICANT, DURING THE COURSE OF CONSTRUCTION, ENCOUNTERS SUCH CONDITIONS AS FLOOD AREAS, UNDERGROUND WATER, SOFT OR SILTY AREAS, IMPROPER DRAINAGE, OR ANY OTHER UNUSUAL CIRCUMSTANCES OR CONDITIONS THAT WERE NOT FORSEEN IN THE ORIGINAL PLANNING, SUCH FENCE (TYP) CONDITIONS SHALL BE REPORTED IMMEDIATELY TO DEME. THE APPLICANT SHALL SUBMIT THEIR EXIST. RECOMMENDATIONS AS TO THE SPECIAL TREATMENT TO BE GIVEN SUCH AREAS TO SECURE ADEQUATE PERMANENT AND SATISFACTORY CONSTRUCTION. DEME SHALL INVESITAGE THE CONDITIONIS), AND SHALL PROP. EITHER APPROVE THE APPLICANT'S RECOMMENDATIONS TO CORRECT THE CONDITIONISI, OR ORDER A DISTURBANCE MODIFICATION THEREOF. IN THE EVENT OF THE (2,000 5F1 APPLICANT'S DISAGREEMENT WITH THE DECISION OF DEME OR IN THE EVENT OF A SIGNIFICANT CHANGE RESULTING TO THE SUBDIVISION PLAN OR SITE PLAN OR ANY CHANGE THAT INVOLVES A WETLAND REGULATED AREA, THE MATTER SHALL BE DECIDED BY THE AGENCY WITH JURISDICTION IN THAT AREAIT WETLANDS-US ARMY CORP. OF ENGINEERS). OVERALL SITE PLAN 8. PERMANENT VEGETATION COVER OF DISTURBED PIERRE CHAUBARD, OWNER AREAS SHALL BE ESTABLISHED ON THE SITE WITHIN THIRTY(30) DAYS OF THE COMPLETION OF SCALE: 1'=20' CONSTRUCTION. 9. PRIOR (AT LEAST 14 DAYS) TO THE PLACING OF TAX MAP SECTION 71.09 ANY ROAD SUB-BASE, THE APPLICANT SHALL PROVIDE THE TOWN OF ORANGETOWN BLOCK | LOT 19 SUPERINTENDENT OF HIGHWAYS AND DEME WITH A SITE PLAN PLAN AND PROFILE OF THE GRADED ROAD TO BE PAVED IN ORDER THAT THESE DEPARTMENTS MAY REVIEW THE DRAWINGS CONFORMANCE TO THE FOR APPROVED CONSTRUCTION PALNS AND THE TOWN CHAUBARD STREET SPECIFICATIONS. 10. THE PLANNING BOARD SHALL RETAIN JURISDICTION OVER LIGHTING LANDSCAPING, SIGNS AND REFUSE CONTROL. 1021 ROUTE 9W TOWN OF ORANGETOWN II. ZONE R-22 12. DISTRICTS: ROCKLAND COUNTY, NEW YORK SOUTH NYACK FIRE DISTRICT SOUTH ORANGETOWN CENTRAL SCHOOL DISTRICT SCHOOL: GRAPHIC SCALE WATER: TOWN OF ORANGETOWN TOWN OF DRANGETOWN SEWER: UNAUTHORIZED ALTERATION OR ADDITION TO THIS PLAN IS A VIOLATION OF SECTION 720912) OF THE NEW YORK STATE EDUCATION LAW. COPIES OF THIS DRAINAGE AREA NO MORE THAN 1/4 ACRE PER 100 FEET OF MAP NOT HAVING THE SEAL OF THE SURVEYOR STRAW BALE DIKE FOR SLOPES LESS THAN 25%. ( IN FEET ) OR ENGINEER SHALL NOT BE VALID. 1 inch = 20 ft.CERTIFICATIONS ARE NOT TRANSFERABLE TO ANGLE FIRST STAKE TOWARDS ADDITIONAL INSTITUTIONS OR SUBSEQUENT OWNERS. USE OF UNSEALED COLES, DITLIS DOCUMENT IN ANY COURT, FILE CLASSIC TRANSACTION, OR FILING WITH ANY COLETON OF AN UNAUTHER TO USE ANY COLETON OF 1021RT9W PAUL GDANSKI, PE, PLLU 2, EACH BALE SHALL BE EMBEDDED IN THE SOIL A MINIMUM OF (4) INCHES, AND FEDERAL 633 WOODMONT LANE R 2"X2" STAKES PLACED 3. BALES SHALL BE SECURELY ANCHORED IN PLACE BY EITHER TWO STAKES OR RE-BARS DRIVEN THROUGH THE BALE. THE FIRST STAKE IN EACH BALE SHALL BE DRIVEN TOWARD THE PREVIOUSLY LAID BALE AT AN ANGLE TO FORCE THE MAR. 29, 2023 UNDERGROUND UTILITIES ARE SHOWN IN AN APPROXIMATE WAY FROM SLOATSBURG, N.Y. 1097401 AVAILABLE INFORMATION. THE CONTRACTOR SHALL CALL THE LOCAL RIVE STAKES FLUSH WITH TEL: (917) 418-0999 UNDERGROUND FACILITIES PROTECTIVE ORGANIZATION TO HAVE ALL BALES TOGETHER. STAKES SHALL BE DRIVEN FLUSH WITH THE BALE. UNDERGROUND UTILITIES MARKED IN THE HELD PRIOR TO ANY CLEARING 4. INSPECTION SHALL BE FREQUENT AND REPAIR REPLACEMENT SHALL BE MADE 1"=20" OR ANY CONSTRUCTION. THE CONTRACTOR SHALL ALSO VERIFY THE LOCATION, SIZE AND INVERT OF ALL UTILITIES PRIOR TO ANY CONSTRUCTION SPECIFICATIONS 5. BALES SHALL BE REMOVED WHEN THEY HAVE SERVED THEIR USEFULINESS SO CONSTRUCTION. ANY UTILITY FOR WHICH NO EVIDENCE CAN BE SEEN ON AS NOT TO BLOCK OR IMPEDE STORM FLOW OR DRAINAGE. STRAW BALT DIKE 1. BALES SHALL BE PLACED AT THE TOE OF A SLOPE OR ON THE CONTOUR AND IN A ROW WITH ENDS TIGHTLY ABUTTING THE ADJACENT BALES. THE SURFACE OF THE LANDS MAY NOT BE SHOWN ON THIS DRAWING. 1 OF 1

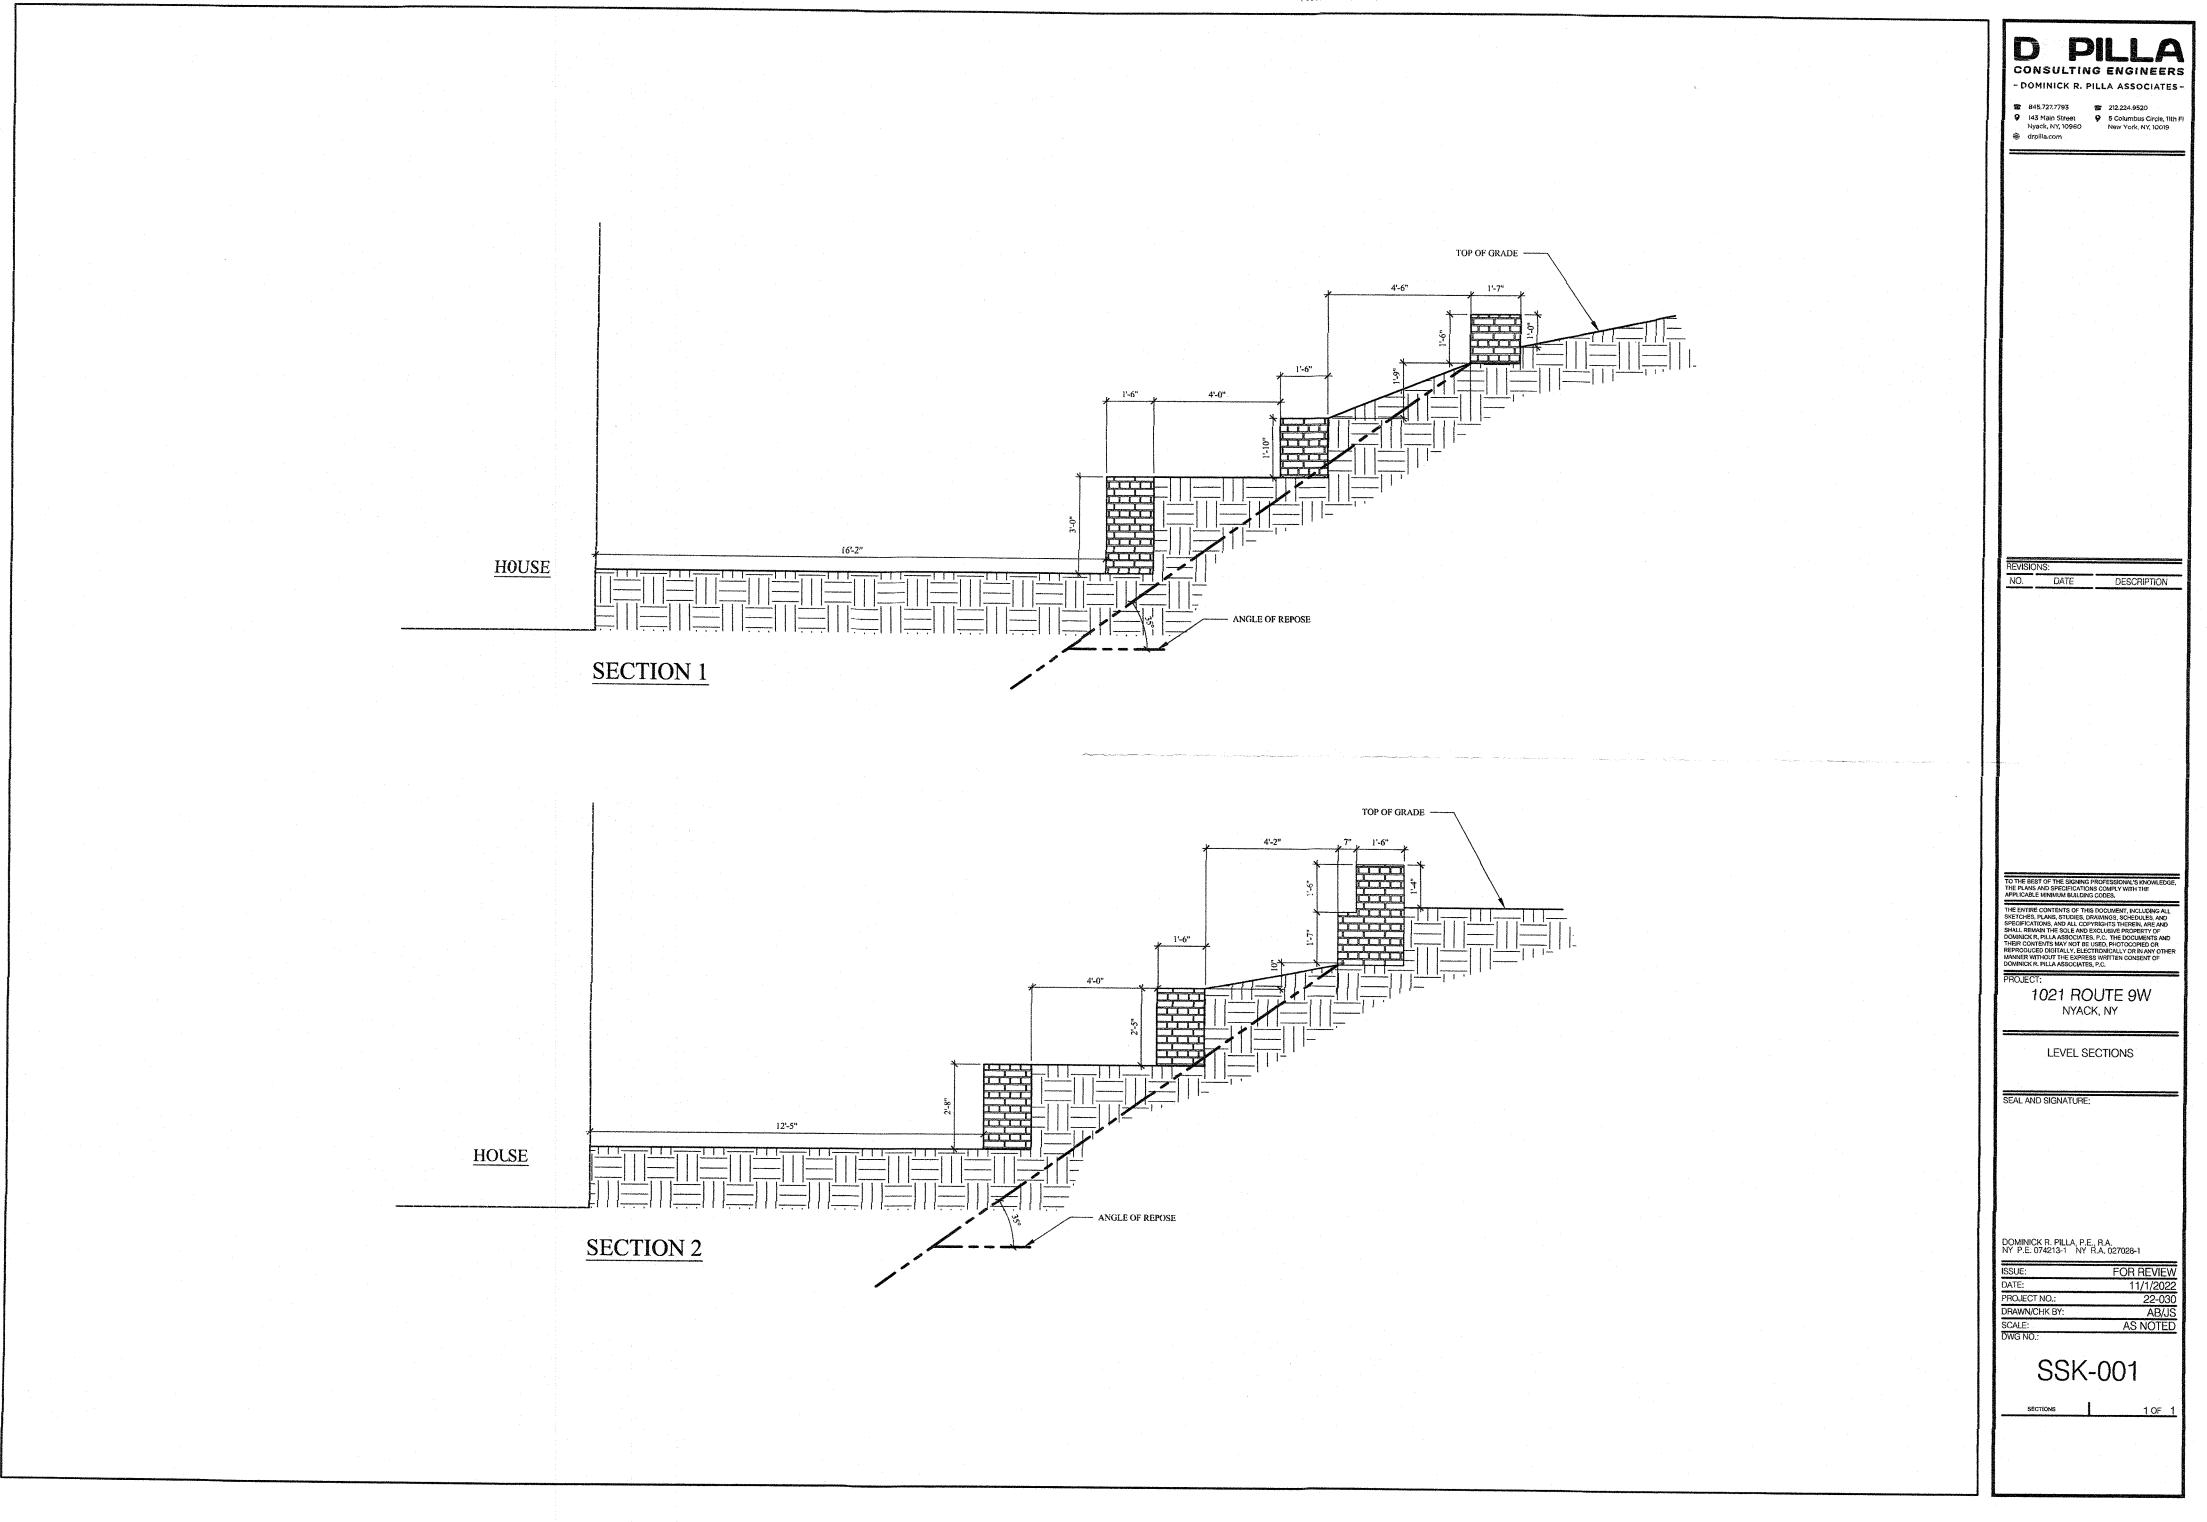

318.28' N 83°34'00" E さって mining CELLAR ENTRANCE jamijaroj TWO & A HALF STORY S 226.2' 305.08 S 84°24'21" W ALL NOTES IN RED ARE MARKED UP BY DRPILLA ON 11/02/2022 AND

LOT ARE CONTRACTED STARTED FROM

## SURVEY FOR 1021 RT 9W

TOWN OF ORANGETOWN, ROCKLAND COUNTY

NYACK, NEW YORK

JUNE 21, 2021 SCALE: 1" = 20'

0 20 40 60 ANTHONY R. CELENTANO P.L.S. 31 ROSMAN ROAD THIELLS,N.Y. 10984 845 429 5290 FAX 429 5974

anthonya Celutano