


	BULK REG	ULATIONS	ě.
R-22	REQUIRED	EXISTING	TO POOL
LOT AREA	22,500 SF	39,100 SF	NO CHANGE
LOT WIDTH	125 Ft	110'± 🕀	NO CHANGE
MIN STREET FRONTAGE	75 Ft	112.35'	NO CHANGE
FRONT YARD	40 Ft	32.6'⊕	NO CHANGE
SIDE YARD	25 Ft	15.2' 🕀	29.7' TO POOL(WATER)
TOTAL SIDE YARD	60 Ft	41.3'	61.8' TO POOL(WATER)
REAR YARD	45 Ft	>200'	160.7'
FLOOR AREA RATIO	0.20	0.15± PER ARCHT	NO CHANGE
BUILDING HEIGHT	9"/FT FROM LOT LINE (32.6×9/12=24.4')	28'±	NO CHANGE
·			

EXISTING NON-CONFORMING CONDITION

BULK REGULATIONS				
R-15	REQUIRED			
LOT AREA	15,000 SF			
LOT WIDTH	100 Ft			

FRONT YARD	40 Ft			
SIDE YARD	20 Ft			
TOTAL SIDE YARD	50 Ft			
REAR YARD	45 Ft			
FLOOR AREA RATIO	0.20			
BUILDING HEIGHT	1'-0"/FT FROM LOT LINE			

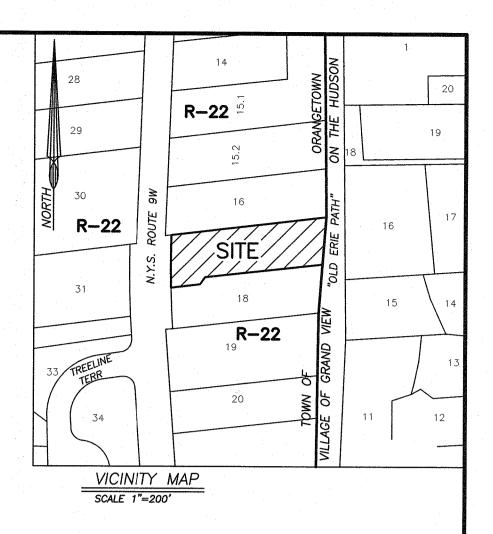

1. THIS IS A SITE PLAN OF TAX LOT 71.09-1-17 AS SHOWN ON THE TOWN OF ORANGETOWN TAX MAPS.
2. RECORD OWNER: LISA FERRANTE, 1031 ROUTE 9W, UPPER GRANDVIEW, NEW YORK 10960
3. APPLICANT: SAME

4. ZONE: R-22

5. ALL NEW UTILITIES, INCLUDING ELECTRIC AND TELEPHONE SERVICE SHALL BE INSTALLED UNDERGROUND.
6. THIS PLAT DOES NOT CONFLICT WITH THE COUNTY OFFICIAL MAP, AND HAS BEEN APPROVED IN THE MANNER SPECIFIED BY SECTION 239 L&M OF THE GENERAL MUNICIPAL LAW OF THE STATE OF NEW YORK. 7. THIS PLAT IS SUBJECT TO DETAILS OF GRADING, ROADS AND UTILITIES AS SHOWN ON CONSTRUCTION PLANS APPROVED BY THE PLANNING BOARD AND FILED WITH THE TOWN CLERK. LOT DRAINAGE SHOWN ON SUCH PLANS SHALL CONSTITUTE EASEMENTS RUNNING WITH THE LAND & SHALL NOT BE DISTURBED. 8. ANY EXISTING UTILITIES (POLES, HYDRANTS, ETC.) AFFECTED BY CONSTRUCTION OF THIS SITE PLAN SHALL BE RELOCATED AT THE DEVELOPERS EXPENSE PRIOR TO THE ISSUANCE OF ANY CERTIFICATE OF OCCUPANCY.

10. DATUM: USGS (NAVD 88) 11. THE NEW CORNERS OF ALL LOTS SHALL BE MARKED WITH METAL RODS 3/4" IN DIAMETER & AT LEAST 30" IN LENGTH, TO BE INSTALLED AFTER 12. ALL AREAS DISTURBED BY ON-SITE GRADING SHOULD BE LIMED AND FERTILIZED PRIOR TO SEEDING. PERMANENT VEGETATION COVER OF DISTURBED AREAS SHALL BE ESTABLISHED ON THE SITE WITHIN (30) DAYS OF THE COMPLETION OF CONSTRUCTION. 13. AT LEAST ONE WEEK PRIOR TO THE COMMENCEMENT OF ANY WORK, INCLUDING THE INSTALLATION OF EROSION CONTROL DEVICES OR THE REMOVAL OF TREES & VEGETATION, A PRE-CONSTRUCTION MEETING MUST BE HELD WITH THE TOWN OF ORANGETOWN DEME, SUPT. OF HIGHWAYS AND THE

OFFICE OF BUILDING, ZONING & PLANNING ADMINISTRATION AND ENFORCEMENT. IT IS THE RESPONSIBILITY AND OBLIGATION OF THE PROPERTY OWNER TO ARRANGE SUCH A MEETING. 14. PLANS COMPLY WITH STORMWATER MANAGEMENT PHASE II REGULATIONS FOR PROJECTS WITH LESS THAN ONE ACRE OF DISTURBANCE. AN EROSION AND SEDIMENT CONTROL PLAN HAS BEEN PREPARED, AND NO NOI FILING IS REQUIRED. 15. ALL LANDSCAPING SHOWN ON THE SUBDIVISION PLANS SHALL BE MAINTAINED IN A VIGOROUS GROWING CONDITION THROUGHOUT THE DURATION OF

16. PRIOR TO THE COMMENCEMENT OF ANY SITE WORK, INCLUDING THE REMOVAL OF TREES, THE APPLICANT SHALL INSTALL THE SOIL EROSION & SEDIMENTATION CONTROL AS REQUIRED BY THE PLANNING BOARD. PRIOR TO THE AUTHORIZATION TO PROCEED WITH ANY PHASE OF THE SITE WORK, TO THE AUTHORIZATION TO PROCEED WITH ANY PHASE OF THE SITE WORK, THE TOWN D.E.M.E. SHALL INSPECT THE INSTALLATION OF ALL REQUIRED SOIL EROSION & SEDIMENTATION CONTROL MEASURES THE APPLICANT SHALL CONTACT DEME AT LEAST 48 HOURS IN ADVANCE FOR AN INSPECTION.

17. THE TREE PROTECTION AND PRESERVATION GUIDELINES ADOPTED PURSUANT TO SECTION 21-24 OF THE LAND DEVELOPMENT REGULATIONS OF THE TOWN OF ORANGETOWN WILL BE IMPLEMENTED IN ORDER TO PROTECT AND PRESERVE BOTH INDIVIDUAL SPECIMEN TREES AND BUFFER AREAS WITH MANY TREES. STEPS THAT WILL BE TAKEN TO PRESERVE AND PROTECT EXISTING TREES ARE AS FOLLOWS: a. NO CONSTRUCTION EQUIPMENT SHALL BE PARKED UNDER THE TREE CANOPY.

THE USE OF THIS SITE. ANY PLANTS NOT SO MAINTAINED SHALL BE REPLACED WITH NEW PLANTS AT THE BEGINNING OF THE NEXT IMMEDIATELY

b. THERE WILL BE NO EXCAVATION OR STOCKPILING OF EARTH UNDERNEATH TREES. c. TREES DESIGNATED TO BE PRESERVED SHALL BE MARKED CONSPICUOUSLY ON ALL SIDES AT A 5 TO 10 FOOT HEIGHT.

d. THE TREE PROTECTION ZONE FOR TREES DESIGNATED TO BE PRESERVED WILL BE ESTABLISHED BY ONE OF THE FOLLOWING

1. ONE (1) FOOT RADIUS FROM TRUNK PER INCH DBH 2. DRIP LINE OF THE TREE CANOPY

THE METHOD CHOSEN SHOULD BE BASED ON PROVIDING THE MAXIMUM PROTECTION ZONE POSSIBLE. A BARRIER OF SNOW FENCE OR EQUAL IS TO BE PLACED AND MAINTAINED ONE YARD BEYOND THE ESTABLISHED TREE PROTECTION ZONE. IF IT IS AGREED THAT THE TREE PROTECTION ZONE OF A SELECTED TREE MUST BE VIOLATED, ONE OF THE FOLLOWING METHODS MUST BE EMPLOYED TO MITIGATE THE IMPACT: 1. LIGHT TO HEAVY IMPACTS— MINIMUM OF EIGHT INCHES OF WOOD CHIPS INSTALLED IN THE AREA TO BE PROTECTED. CHIPS SHALL BE REMOVED UPON COMPLETION OF WORK.

2. LIGHT IMPACTS ONLY- INSTALLATION OF 3/4 INCH OF PLYWOOD OR BOARDS, OR EQUAL OVER THE AREA TO BE PROTECTED. THE BUILDER OR ITS AGENT MAY NOT CHANGE GRADE WITHIN THE TREE PROTECTION ZONE OF A PRESERVED TREE UNLESS SUCH GRADE CHANGE HAS RECEIVED FINAL APPROVAL FROM THE PLANNING BOARD. IF THE GRADE LEVEL IS TO BE CHANGED MORE THAN SIX (6) INCHES TREES DESIGNATED TO BE PRESERVED SHALL BE WELLED AND/OR PRESERVED IN A RAISED BED, WITH THE TREE WELL RADIUS OF THREE (3) FEET LARGER THAN THE TREE CANOPY.

18. IF THE APPLICANT, DURING THE COURSE OF CONSTRUCTION, ENCOUNTERS SUCH CONDITIONS AS FLOOD AREAS, UNDERGROUND WATER, SOFT OR SILTY AREAS IMPROPER DRAINAGE, OR ANY OTHER UNUSUAL CIRCUMSTANCES OR CONDITIONS THAT WERE NOT FORSEEN IN THE ORIGINAL PLANNING, SUCH CONDITIONS SHALL BE REPORTED IMMEDIATELY TO DEME. THE APPLICANT SHALL SUBMIT THEIR RECOMMENDATIONS AS TO THE SPECIAL TREATMENT TO BE GIVEN SUCH AREAS TO SECURE ADEQUATE, PERMANENT AND SATISFACTORY CONSTRUCTION. DEME SHALL INVESTIGATE THE CONDITION(SO, AND SHALL EITHER APPROVE THE APPLICANT'S RECOMMENDATIONS TO CORRECT THE CONDITIONS, OR ORDER A MODIFICATION THEREOF. IN THE EVENT OF THE APPLICANT'S DISAGREEMENT WITH THE DECISION OF DEME, OR IN THE EVENT OF A SIGNIFICANT CHANGE RESULTING TO THE SUBDIVISION PLAN OR SITE PLAN OR ANY CHANGE THAT INVOLVES A WETLAND REGULATED AREA, THE MATTER SHALL BE DECIDED BY THE AGENCY WITH JURISDICTION IN THAT AREA (ie WETLAND-US ARMY CORPS OF ENGINEERS) 19. THE CONTRACTOR'S TRAILER, IF ANY IS PROPOSED, SHALL BE LOCATED AS APPROVED BY THE PLANNING BOARD.

20.THE PLANNING BOARD SHALL RETAIN JURISDICTION OVER LIGHTING, LANDSCAPING, SIGNS AND REFUSE CONTROL.

WATER SUPPLY: WELLS

FOLLOWING GROWING SEASON.

LEGEND			
DRAINAGE INLET W/PIPES DRAIN MANHOLE/ WITH PIPES TOP CURB @ CATCH BASIN TOP GRATE FIELD INLET REINFORCED CONCRETE PIPE	TCCB TGFI RCP	GAS VALVE OVERHEAD WIRES — GAS LINE — GAS, ELEC, TEL — WATER LINE — CONTOUR LINE	GV
CORRUGATED PLASTIC PIPE UTILITY POLE UTILITY POLE WITH LIGHT	CPP UP \Q	SPOT ELEVATION BUILDING ENTRANCE	256.2 X ◀
WATER VALVE HYDRANT	WV ○ HYD ⟨◯>		

11/16/21 11/08/21	NOTES FIELD REVS/BULK	AS BUILT POOL SITE P
5/04/21	BULK REGULATIONS	
DATE	REVISIONS	FERRANTE
THE STATE OF THE PROPERTY OF T	GREEN THE	1031 ROUTE 9W SOUTH UPPER GRANDVIEW, TOWN OF ORAN STATE OF NEW YORK
		JAY A. GREENWELL, P
	A. GREENWELL, PLS YS LIC. # 49676	SURVEYING — LAND PLANNING 85 LAFAYETTE AVENUE, SUFFERN, NEW Y PHONE 845—357—0830 FAX 84 © 2021 GREENWELL SURVEYING, 20

TO BOILT TOOL OHE TENT	71.09-1-
FERRANTE	AREA 39,100
1031 ROUTE 9W SOUTH UPPER GRANDVIEW, TOWN OF ORANGETOWN	FILE 22022 SIT
STATE OF NEW YORK	SCALE
JAY A. GREENWELL, PLS, LLC	1"= 20
) 10)	DATE

TAX LOT #

JOB NO.

22022

AUG. 27, 2020 YORK, 10901 345-357-0756 2020

DISTRICTS

SCHOOL: NYACK UNION FREE FIRE: UPPER GRANDVIEW FD007 WATER: UPPER GRANDVIEW WT005

SEWER: ORANGETOWN SEWER DISTRICT

LIBRARY: NYACK LBNYACK AMBULANCE: NYACK AMOO2

1. BEING LOT 1 ON A MAP ENTITLED "MINOR SUBDIVISION FOR 607 HOMES", FILED IN THE ROCKLAND COUNTY CLERK'S OFFICE AS MAP 6386.

2. DEEDS ON FILE IN THE ROCKLAND COUNTY CLERK'S AS FOLLOWS: INST# 2001-16340, INST# 2015-28393, INST# 2013-30504.